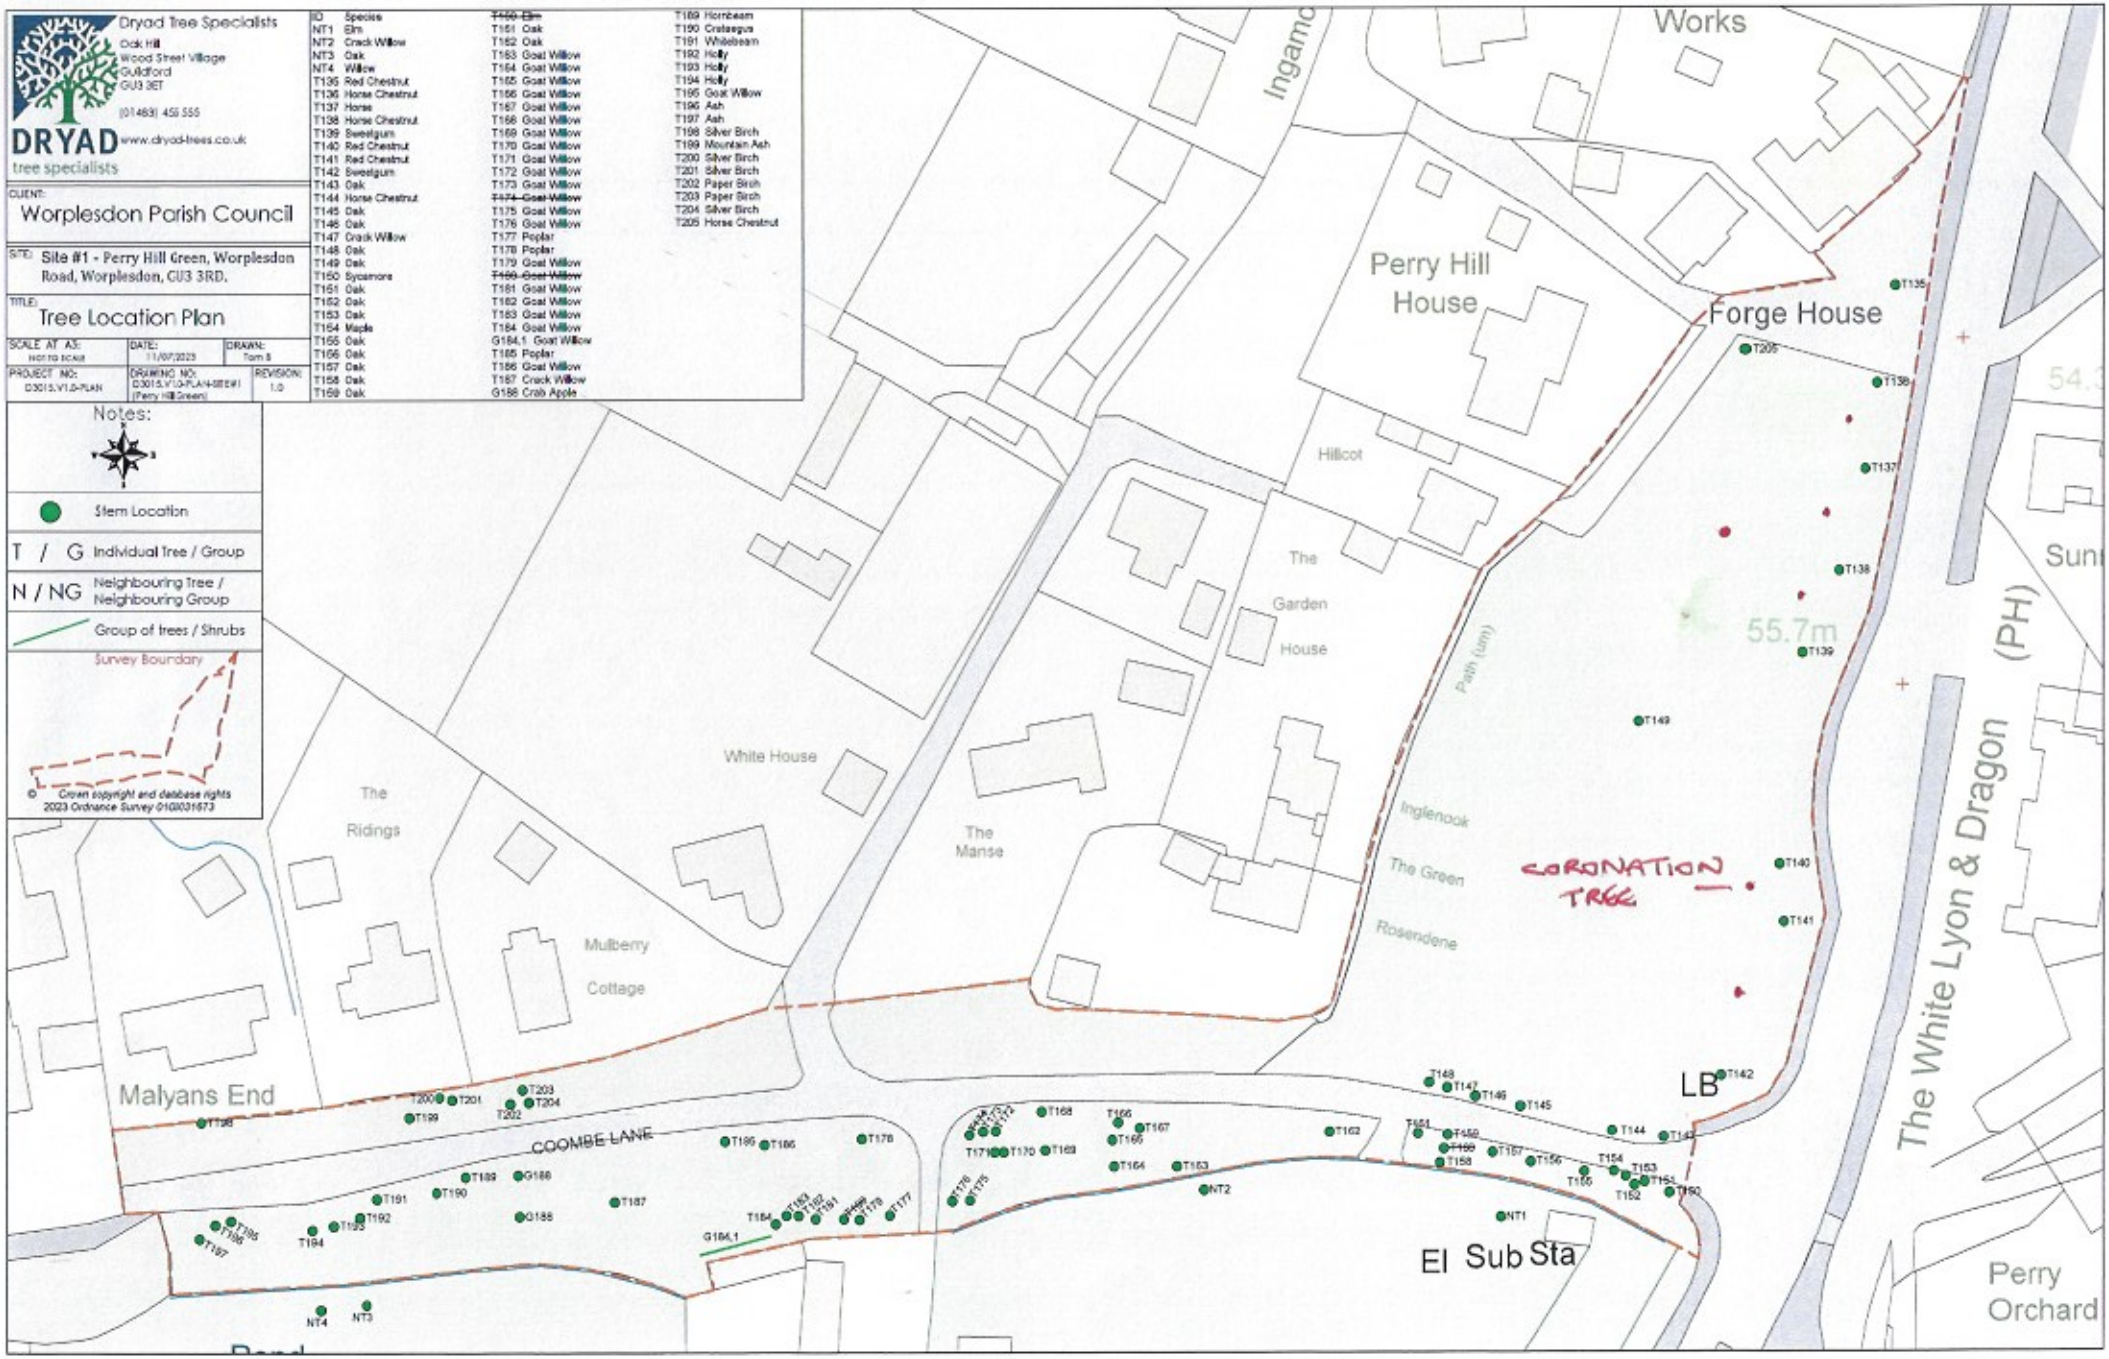
Dryad Tree Specialists
Oak Hill
Wood Street Village
Guildford
GU3 3ET
(01483) 455 555
DRYAD
www.dryad-trees.co.uk
tree specialists
CLIENT:
Worplesdon Parish Council
SITE:
Site #1 - Perry Hill Green, Worplesdon Road, Worplesdon, GU3 3RD.
TITLE:
Tree Location Plan
SCALE AT A3:
NOT TO SCALE
DATE:
11/07/2023
DRAWN:
Tom S
PROJECT NO:
D3015.V1.0-PLAN
DRAWING NO:
D3015.V1.0-PLAN-SITE#1 (Perry Hill Green)
REVISION:
1.0
ID Species
NT1 Elm
NT2 Crack Willow
NT3 Oak
NT4 Willow
T136 Red Chestnut
T136 Horse Chestnut
T137 Horse
T138 Horse Chestnut
T139 Sweetgum
T140 Red Chestnut
T141 Red Chestnut
T142 Sweetgum
T143 Oak
T144 Horse Chestnut
T145 Oak
T146 Oak
T147 Crack Willow
T148 Oak
T149 Oak
T150 Sycamore
T151 Oak
T152 Oak
T153 Oak
T154 Maple
T155 Oak
T156 Oak
T157 Oak
T158 Oak
T159 Oak
~~T160 Elm~~
T161 Oak
T162 Oak
T163 Goat Willow
T164 Goat Willow
T165 Goat Willow
T166 Goat Willow
T167 Goat Willow
T168 Goat Willow
T169 Goat Willow
T170 Goat Willow
T171 Goat Willow
T172 Goat Willow
T173 Goat Willow
~~T174 Goat Willow~~
T175 Goat Willow
T176 Goat Willow
T177 Poplar
T178 Poplar
T179 Goat Willow
~~T180 Goat Willow~~
T181 Goat Willow
T182 Goat Willow
T183 Goat Willow
T184 Goat Willow
G184.1 Goat Willow
T185 Poplar
T186 Goat Willow
T187 Crack Willow
G188 Crab Apple
T189 Hornbeam
T190 Crataegus
T191 Whitebeam
T192 Holly
T193 Holly
T194 Holly
T195 Goat Willow
T196 Ash
T197 Ash
T198 Silver Birch
T199 Mountain Ash
T200 Silver Birch
T201 Silver Birch
T202 Paper Birch
T203 Paper Birch
T204 Silver Birch
T205 Horse Chestnut
Notes:
Stem Location
T / G Individual Tree / Group
N / NG Neighbouring Tree / Neighbouring Group
Group of trees / Shrubs
Survey Boundary
© Crown copyright and database rights 2023 Ordnance Survey 0100031673
Perry Hill House
Forge House
Hillcot
The Garden House
White House
The Manse
The Ridings
Mulberry Cottage
Malyans End
COOMBE LANE
Inglenook
The Green
Rosendene
Path (um)
CORONATION TREE
LB
El Sub Sta
The White Lyon & Dragon (PH)
Perry Orchard
Works
55.7m